


1651 HOLLAND STREET

West Columbia, SC, 29169

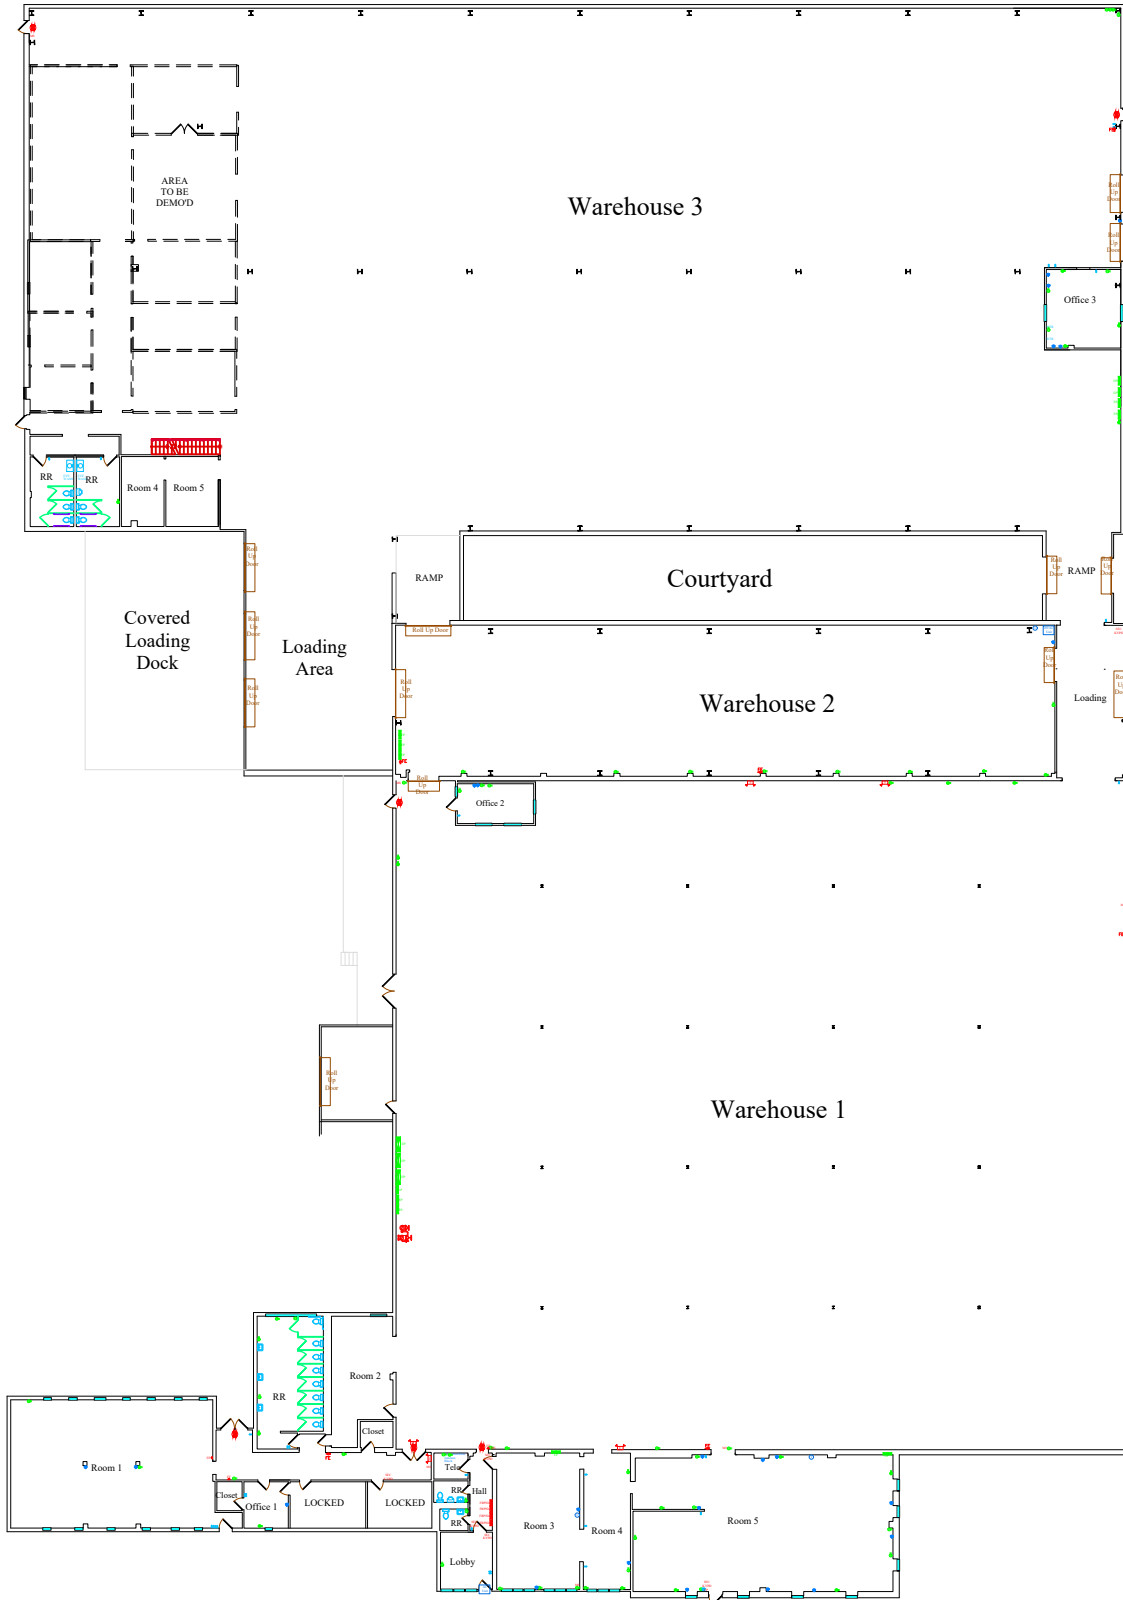

Individual Suite Net S/F	
Space Description	Usable Area
FRONT OFFICE AREA	6897
WAREHOUSE 1	26512
WAREHOUSE 2	5901
WAREHOUSE 3	33116
	72425